


BENCHMARK:  
TOP NUT OF HYDRANT:  
BENDLE CR & BAYCROFT DR = 515.525  
NW CORNER HIEBERT CR = 516.843

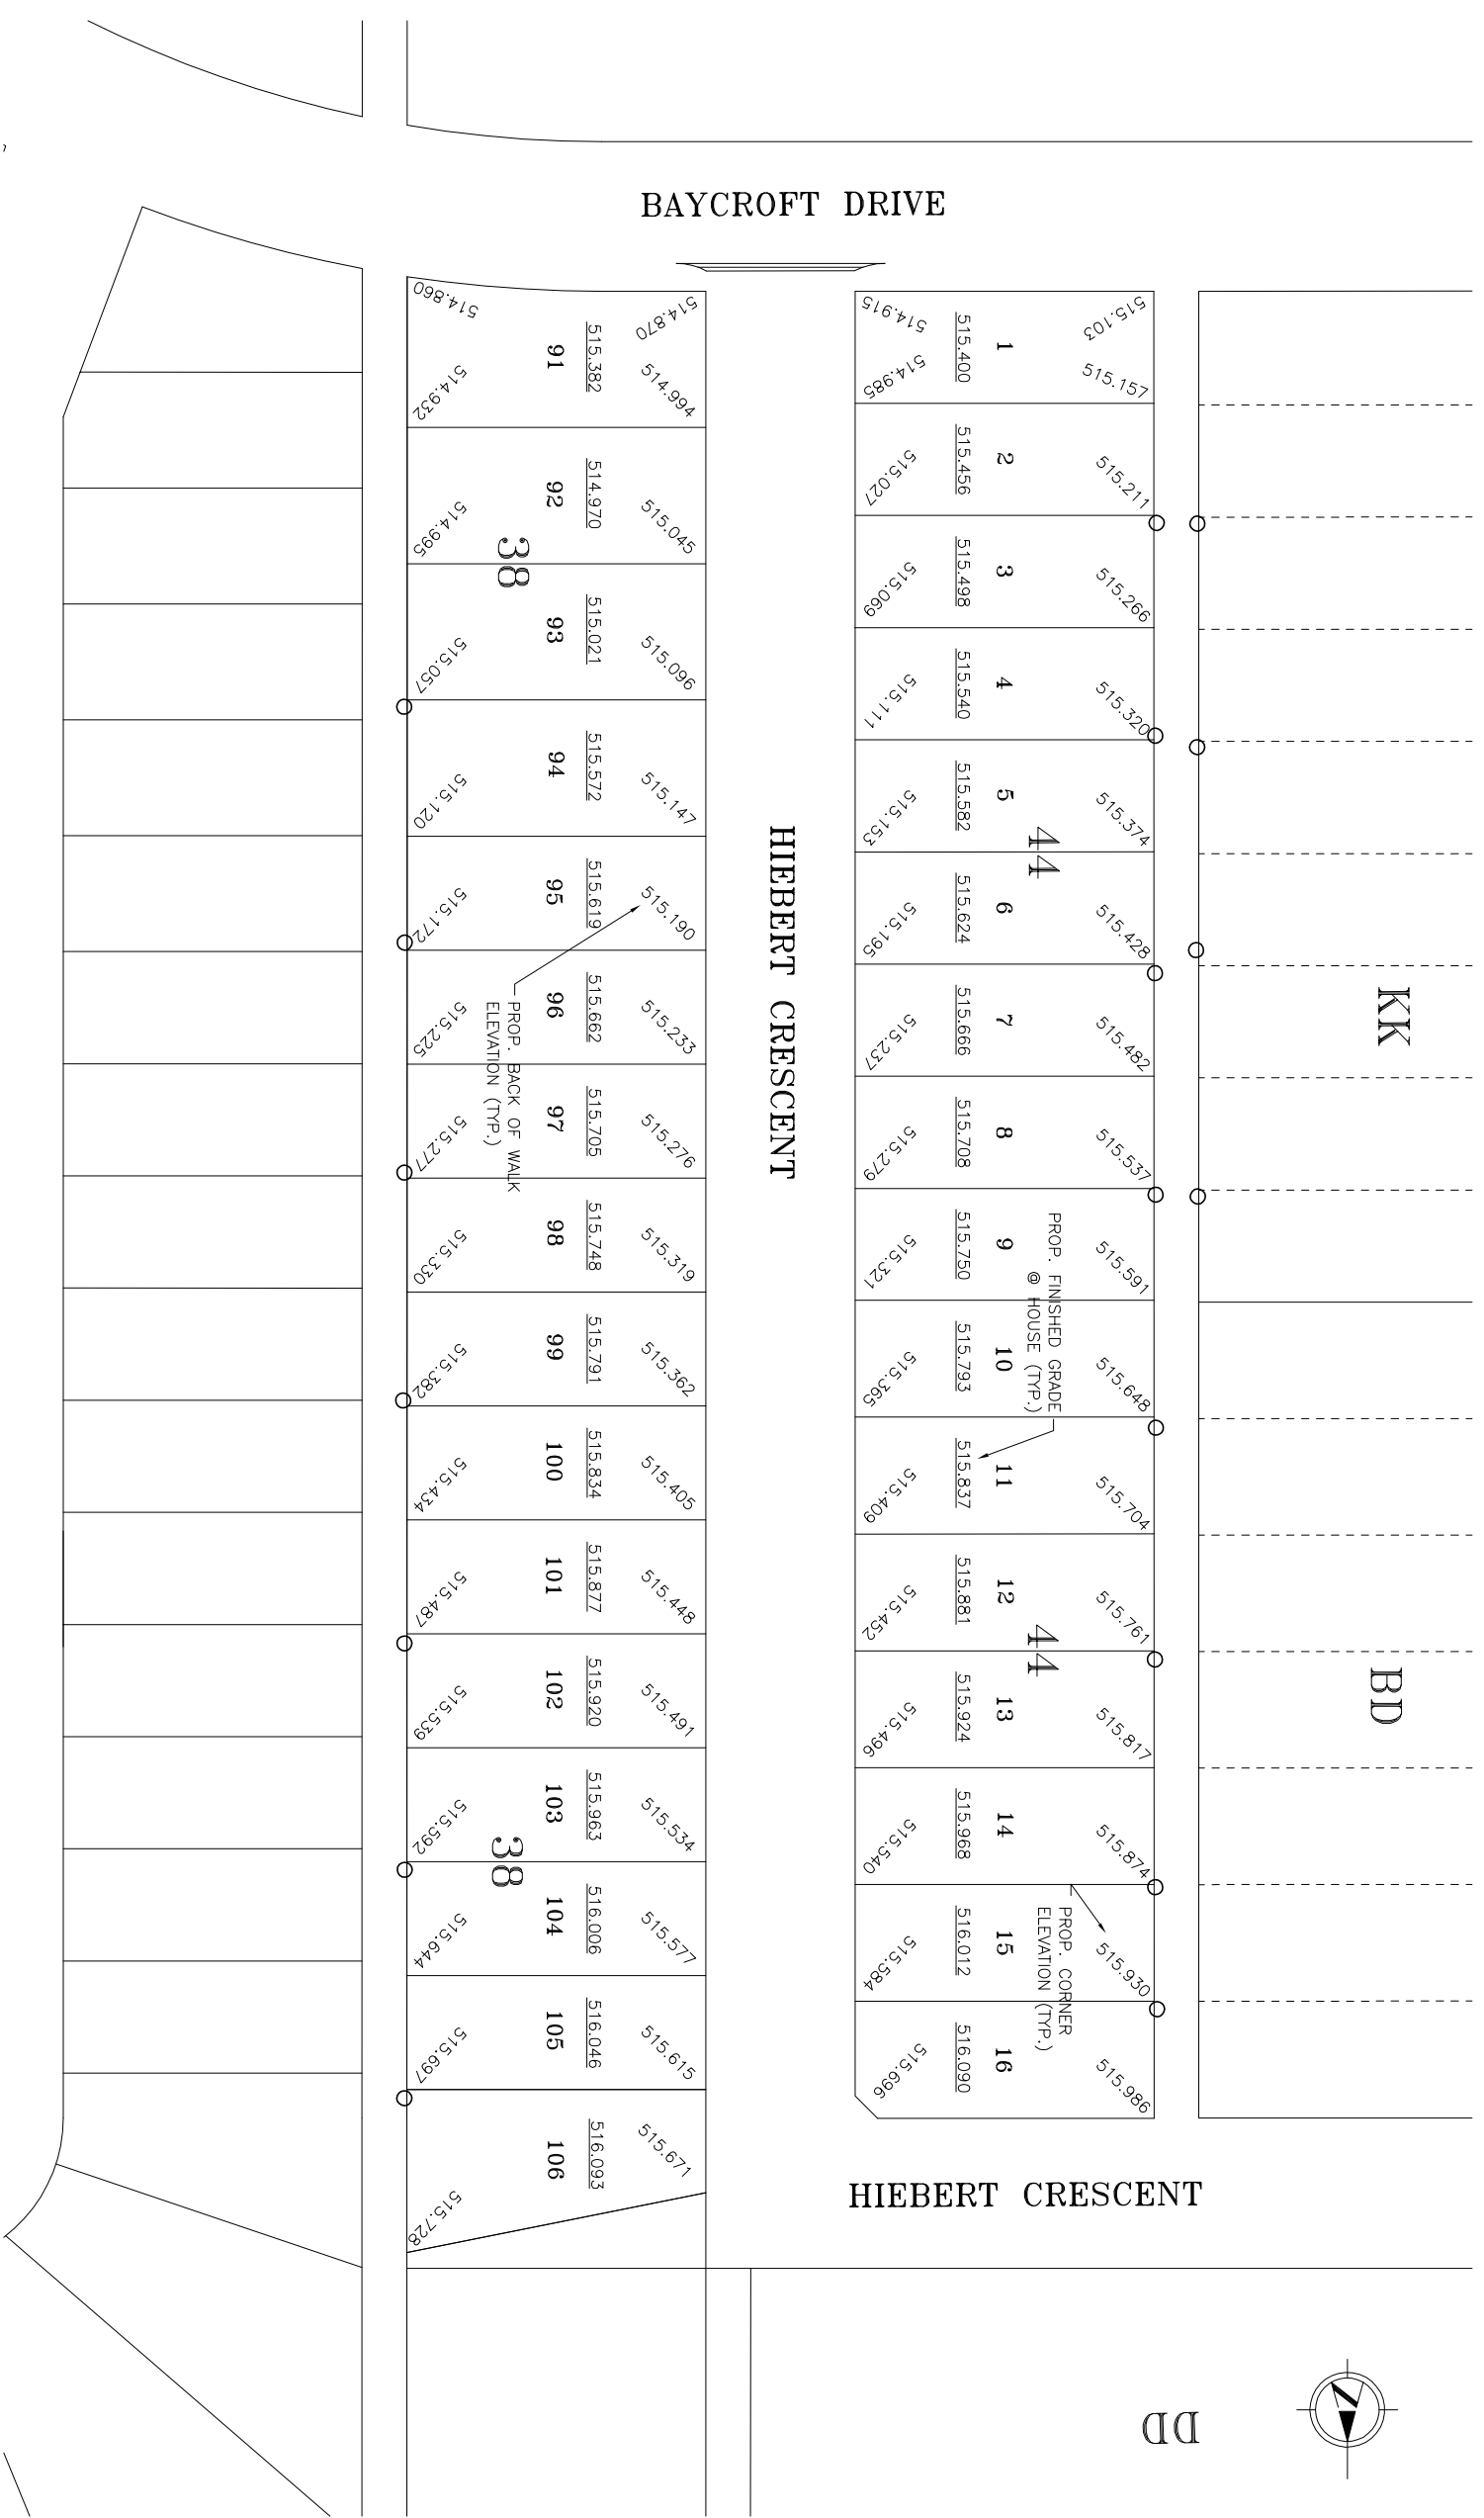

**CATTERALL & WRIGHT**  
CONSULTING ENGINEERS  
1221 - 8th Street East  
SASKATOON SK S7H 0S5  
Tel: (306) 343-7280, Fax: (306) 965-9199

SHEET TITLE		DESIGNED	
HIEBERT CRESCENT EAST LEG LOT GRADE PLAN		CHECKED	
SCALE	1:1000	DATE	06/07/31
DRAWN	C.S.	SHEET	1 of 1
DATE	06/07/31	DRAWING NUMBER	
PROJECT		310-0202	
TOWN of MARTENSVILLE			
KH MANAGEMENT LTD & NORTHERN SKY RESOURCES INC.			
DATE	REVISION		
08/07/22	LOT GRADE FILE AS-BUILT		
07/05/15	ISSUED		